


マイアネタウン第2

(宅地番号 F-31)

出来形測量図

上姉体六丁目 10-1

縮尺=1:500

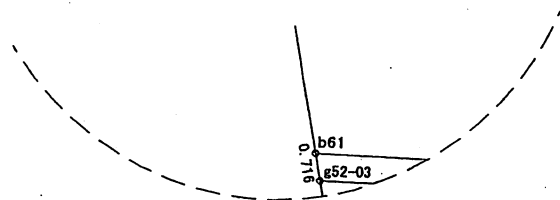

拡大図⑧
S= 1/200

